
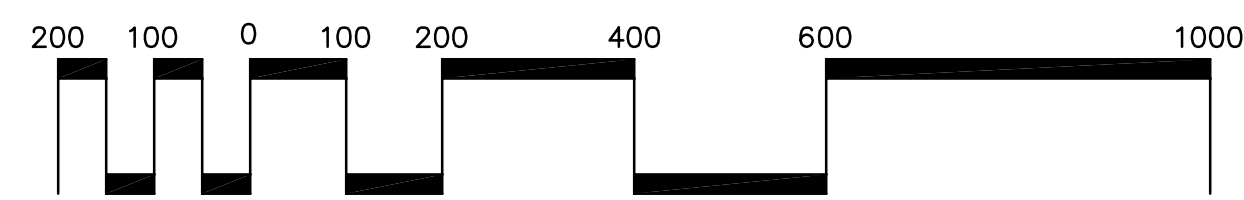


# Masterplan Fort Mill G.C. Fort Mill, S.C.

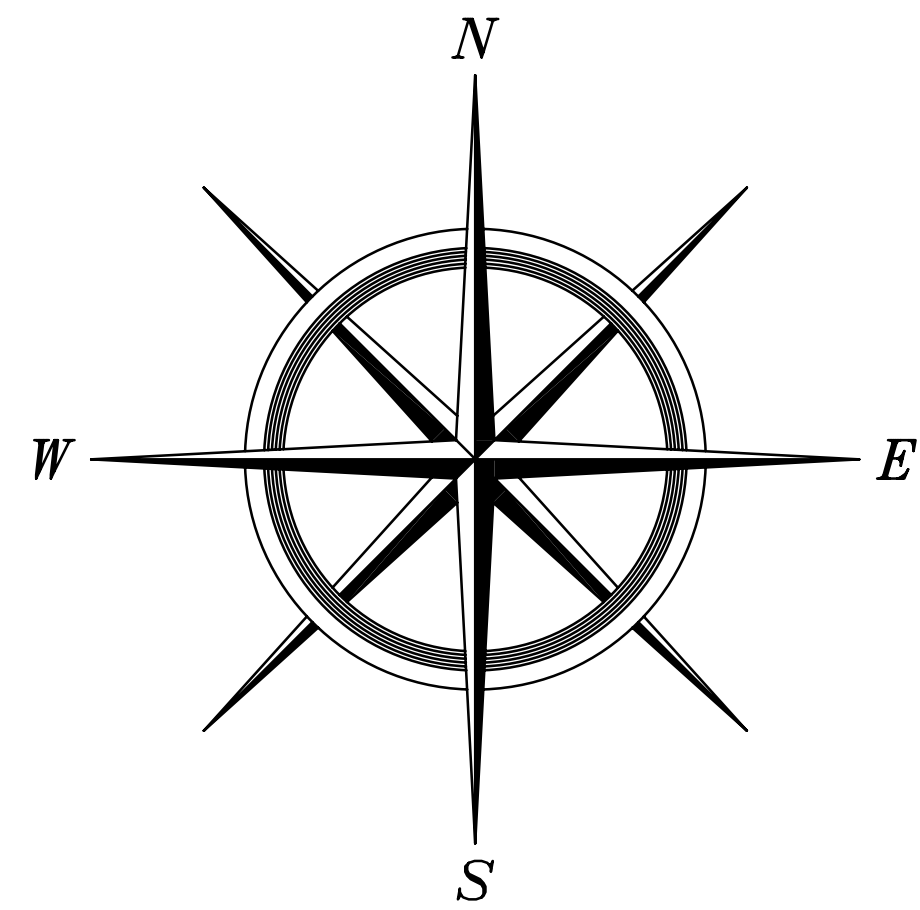

SCALE IN FEET

January 29, 2009

Prepared For  
Leroy Springs & Company, Inc.  
Fort Mill, South Carolina

Prepared By  
Clyde Johnston Designs, Inc.  
Golf Course Architects  
Hilton Head Island, S.C.

